

TAX MAP PARCELS 4-7-9, 9-2-1, 9-2-3, 9-2-4, 9-2-5  
9-2-6, 9-2-7, 9-2-8, 9-7-3, 9-1-5, 9-1-6, 9-1-7,  
9-1-8, 9-7-4, 31-2-2 & 15-1-11

# RECORD DRAWINGS

## ATTACHMENT 1 (VOLUME A)



SEPTEMBER 30, 2008



**MERIDIAN**  
**Land Services, Inc.**  
 STREET ADDRESS: 10 OLD NASHUA RD. SUITE 2, ASHLEY, NC 28005 TEL: 603-675-1444 FAX: 603-675-0004  
 MAILING ADDRESS: PO BOX 88, MILFORD, NH 03060-0088 EMAIL: MERIDIAN@meridianlandservices.com

**ENGINEERS - LAND SURVEYORS - SCIENTISTS - LAND PLANNERS**



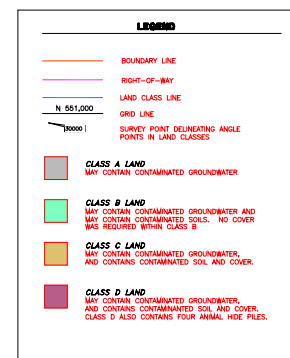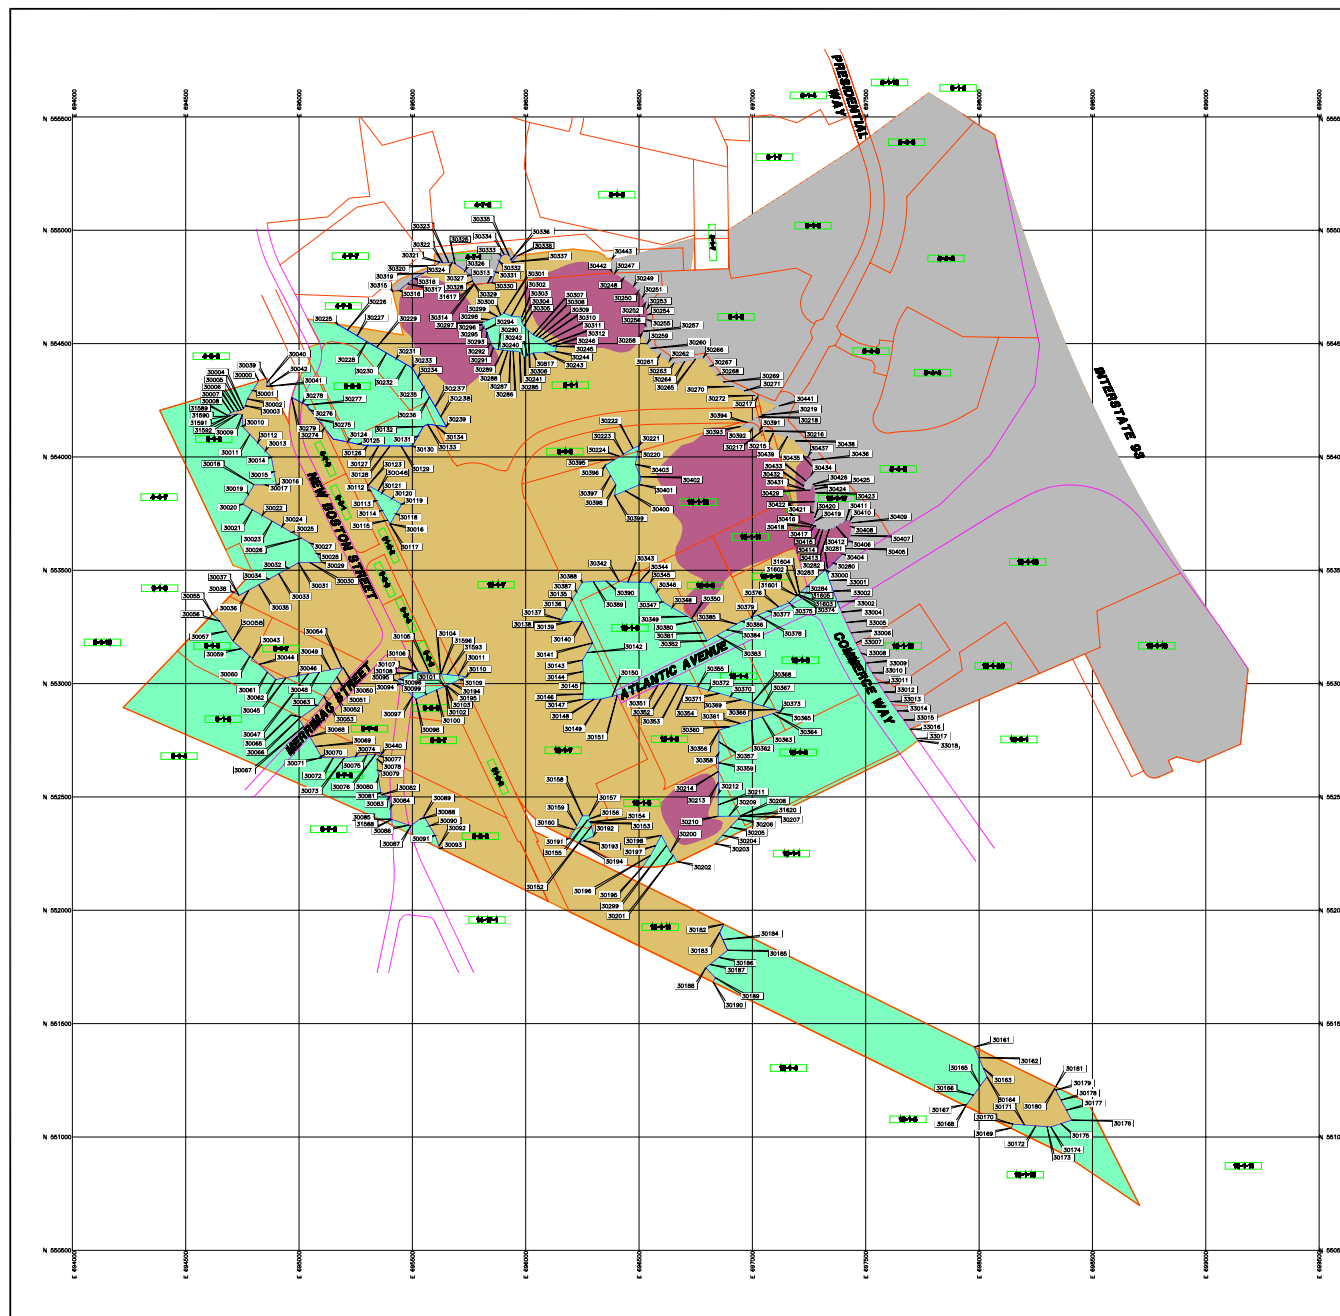




**NOTE**

---


SEE SHEET A-5 FOR NORTHINGS, EASTINGS & INVERSES OF LAND CLASS POINT MARKERS.

DESIGNED BY: <b>MAP</b>		PROJECT: <b>290020</b>	
DRAWN BY: <b>JKW</b>		SHEET NO. <b>1</b>	
CHECKED BY: <b>JKW</b>		DATE: <b>11/11/2003</b>	
FILE: <b>290020.dwg</b>		SCALE: <b>1" = 200'</b>	
<p align="center">  <b>ROUX ASSOCIATES, INC.</b>              Environmental Consulting &amp; Management         </p> <p align="center">  <b>MERIDIAN</b>              Environmental Services, Inc.         </p> <p align="center">  <b>GOLDER ASSOCIATES</b>              Environmental Services, Inc.         </p> <p align="center"> <b>INDUSTRIAL CONTROLS LAND CONSULTING A, B, C</b>  <b>INDUSTRIAL-PLEX SITE REMEDIAL TRUST</b>  <b>WOBURN, MASSACHUSETTS</b> </p>			





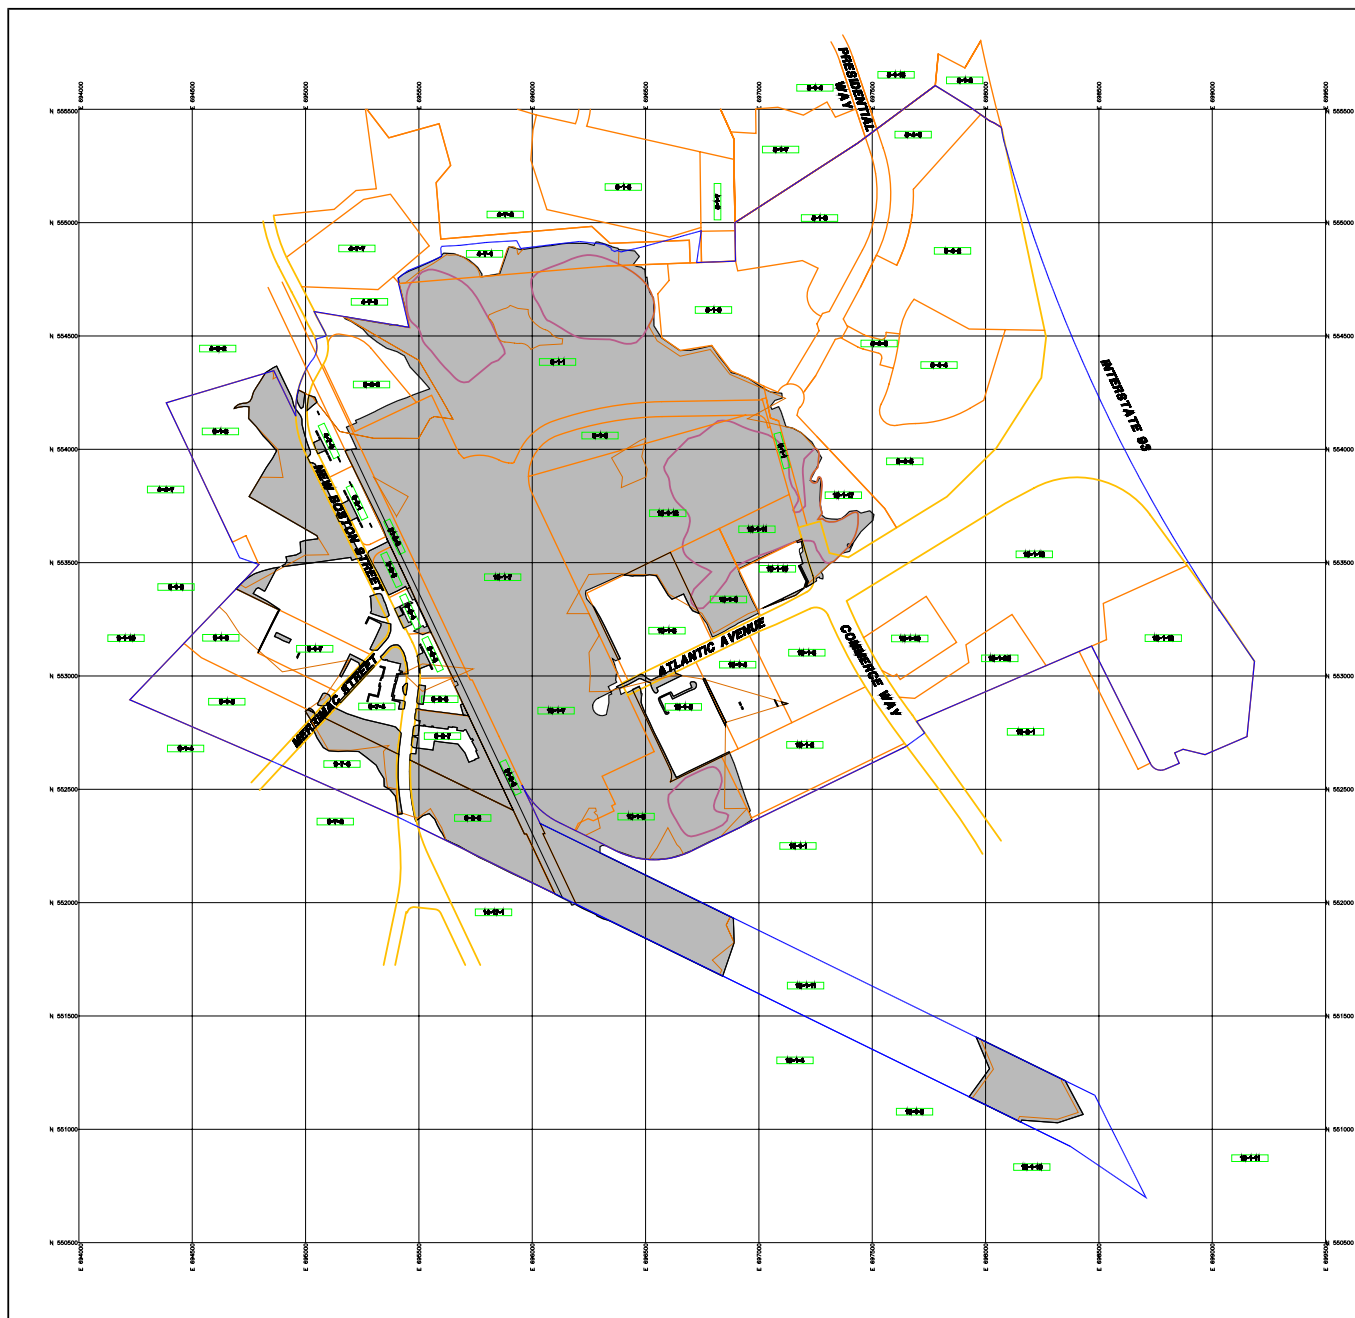

[illegible]